


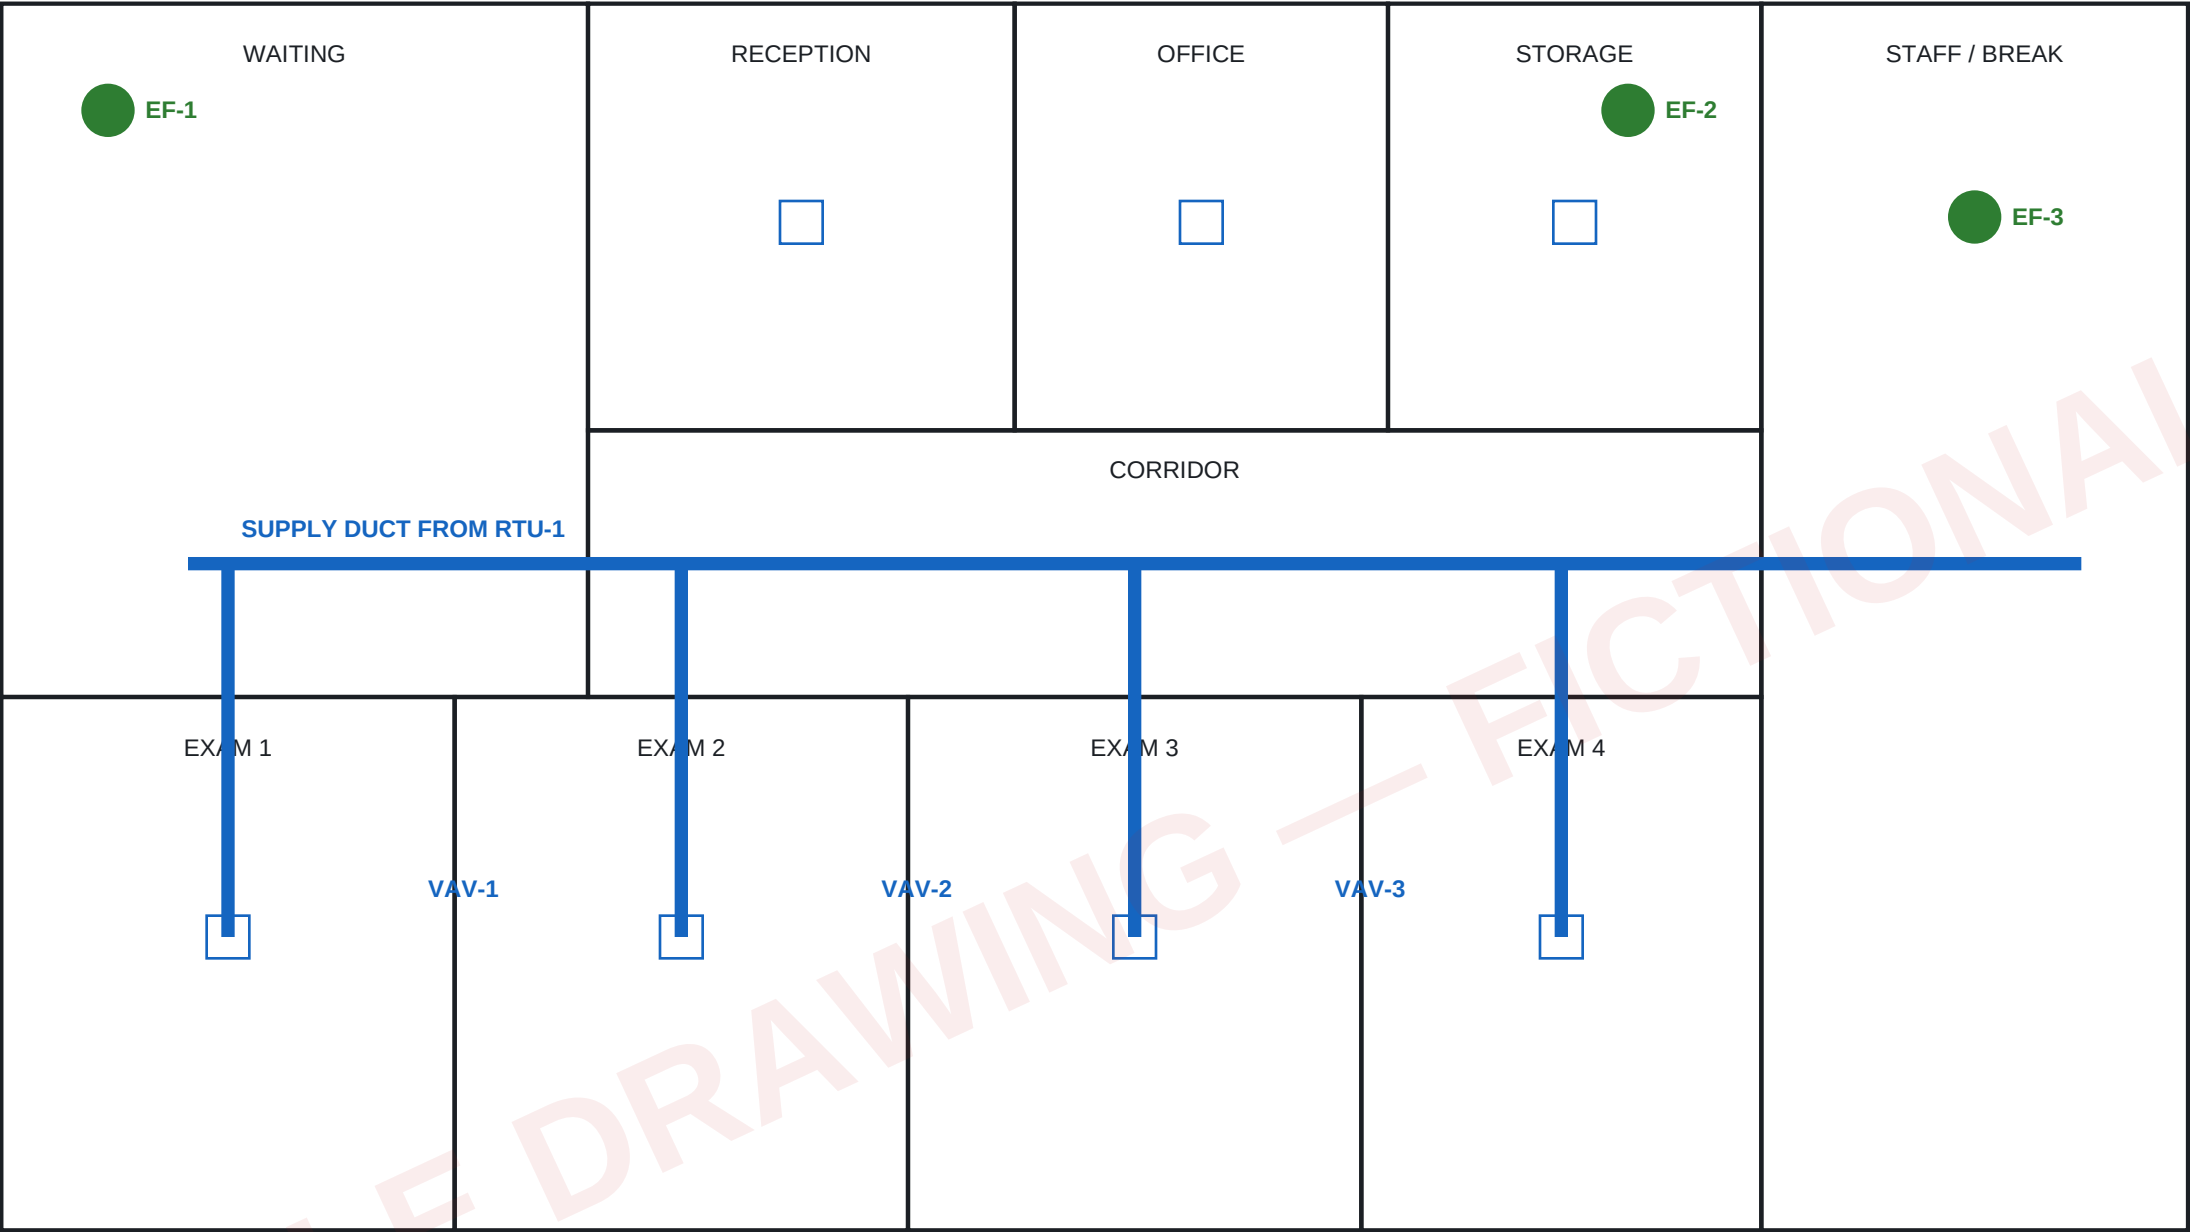

HARBORVIEW FAMILY CLINIC

Tenant fit-out (fictional project) · 2026-014
MECHANICAL PLAN - HVAC

M-101

RECORD DRAWING (SAMPLE)